

Date: Friday, 11/04/2008 9:01:52 AM
 User: Julie Lecocq

Process Sheet

Customer :	CU-DAR001 Dart Helicopters Services	Drawing Name :	TUBE ASSEMBLY
Job Number :	38551		
Estimate Number :	11919		
P.O. Number :		Part Number :	D2003037
This Issue :	11/04/2008	Drawing Number :	UNDER REVIEW 08.04.11
Prsht Rev. :	NC	Project Number :	N/A
First Issue :	//	Drawing Revision :	B
Previous Run :	35294	Material :	
Written By :		Due Date :	21/04/2008
Checked & Approved By :	JL 08.4.11	Qty:	6 Um: Each
Comment :	Est B 00.01.12 Re-format EC		

Additional Product

Job Number:



Seq. #:	Machine Or Operation:	Description :
----------------	------------------------------	----------------------

1.0	M304TR0500W035	304 RD Tube .500 x .035W
-----	----------------	--------------------------



Comment: Qty.: 2.0457 f(s)/Unit Total: 12.2743 f(s)
 304 RD Tube .500 x .035W
 Cut as per template D2003-037 (23.38" long)
 Material: 1/2" A x 0.035" wall AISI 304 SS tubing
 Cut: 23.38" long as per Dwg D2003
 Material: M2650-6 Heat sleeve
 Batch: M106781

Batch: M107403

FF 08-04-17

(6)

2.0	M26506	Firesleeve-crkl .375IDia
-----	--------	--------------------------



Comment: Qty.: 2.0700 f(s)/Unit Total: 12.4200 f(s)
 Firesleeve-crkl .375IDia

FF 08-04-17

(6)

3.0	MS208198J	Sleeve
-----	-----------	--------



Comment: Qty.: 2.0000 Each(s)/Unit Total: 12.0000 Each(s)
 Pick

Qty Part Number Desc Batch:

2 MS20819-8J Sleeve M107799 x 10

M107959 x 2 FF 08-05-15

(6)

4.0	AN8188J	Nut
-----	---------	-----



Comment: Qty.: 2.0000 Each(s)/Unit Total: 12.0000 Each(s)
 Pick

Qty Part Number Desc Batch:

2 AN818-8J Nut M107959

FF 08-05-15

(6)

W/O:		WORK ORDER CHANGES					
DATE	STEP	PROCEDURE CHANGE	By	Date	Qty	Approval Chief Eng / Prod Mgr	Approval QC Inspector

Part No: _____ PAR #: _____ Fault Category: _____ NCR: Yes No DQA: _____ Date: _____

QA: N/C Closed: _____ Date: _____

NCR:		WORK ORDER NON-CONFORMANCE (NCR)						
DATE	STEP	Description of NC Section A	Corrective Action Section B			Verification Section C	Approval Chief Eng	Approval QC Inspector
			Initial Chief Eng	Action Description Chief Eng	Sign & Date			

NOTE: Date & initial all entries

Date: Friday, 11/04/2008 9:01:52 AM
User: Julie Lecocq

Process Sheet

Customer: CU-DAR001 Dart Helicopters Services

Drawing Name: TUBE ASSEMBLY

Job Number: 38551

Part Number: D2003037

Job Number:



Seq. #:

Machine Or Operation:

Description :

5.0

D3158045

Heat Shrink 1" x 4.5"



Comment: Qty: ~~3~~ 1.0000 Each(s)/Unit Total: ~~6.0000~~ Each(s)

Heat Shrink 1" x 4.5"

Pick:

Qty Part Number Description Batch
1 D3158-045 Heat shrink

Batch

B17067

FF 08-04-17

(6)

6.0

SMALL FAB 1

SMALL & MEDIUM FAB RESOURCE 1



Comment: SMALL & MEDIUM FAB RESOURCE 1

Form tube as per template D2003-037

Assemble as per Dwg D2003

→ CONFIRM CUT LENGTH OF TUBE WITH
EWG. 08-04-17

FF 08-05-15

(6)

7.0

QC5

INSPECT WORK TO CURRENT STEP



Comment: INSPECT WORK TO CURRENT STEP

08/05/15 (X6)

8.0

PACKAGING 1

PACKAGING RESOURCE #1



Comment: PACKAGING RESOURCE #1

Identify and Stock

Location: ST192

AS 08/05/15 (X6)

9.0

QC21

FINAL INSPECTION/W/O RELEASE



Comment: FINAL INSPECTION/W/O RELEASE

08/05/16

Job Completion



MF 08-05-15

Dart Aerospace Ltd

W/O:		WORK ORDER CHANGES					
DATE	STEP	PROCEDURE CHANGE	By	Date	Qty	Approval Chief Eng / Prod Mgr	Approval QC Inspector

Part No: _____ PAR #: _____ Fault Category: _____ NCR: Yes No DQA: _____ Date: _____

QA: N/C Closed: _____ Date: _____

NCR:		WORK ORDER NON-CONFORMANCE (NCR)						
DATE	STEP	Description of NC Section A	Corrective Action Section B			Verification Section C	Approval Chief Eng	Approval QC Inspector
			Initial Chief Eng	Action Description Chief Eng	Sign & Date			

NOTE: Date & initial all entries



DESIGN	DRAWN BY	DART AEROSPACE LTD HAWKESBURY, ONTARIO, CANADA	
CHECKED	APPROVED	DRAWING NO.	REV. B
DATE		D2003	SHEET 1 OF 2
99.06.08		TITLE	SCALE
		206 CABIN HEATER TUBE ASSEMBLIES	NTS
A	90.04.09	NEW ISSUE	
B	99.06.08	UPDATE PER TEMPLATES; ADD P/N'S; 0.025 TUBING NOW 0.035 (TSR1049)	

RELEASED
49.06.08 KE

UNDER REVIEW

06.03.21 CB

some flat
lengths wrong

08.04.11

P/N	TEMPLATE	HEATSLEEVE LENGTH ¹	CUT LENGTH OF TUBE ²	MS20819-8J SLEEVE	AN818-8J NUT	MS20819-8D SLEEVE	AN818-8D NUT	MS20819-6D SLEEVE	AN818-6D NUT	DESC.	MATERIAL ^{4/8/7}	VENDOR OR SPEC
D2003-001	T2003-001	5.2	6.00					2	2	TUBE ASS'Y	6061-T6 0.375 OD x 0.035 W	VWV-T-700/6
D2003-003	T2003-003	7.3	8.12					2	2	TUBE ASS'Y	6061-T6 0.375 OD x 0.035 W	VWV-T-700/6
D2003-005	T2003-005	9.8	10.62					2	2	TUBE ASS'Y	6061-T6 0.375 OD x 0.035 W	VWV-T-700/6
D2003-007	T2003-007	20.0	19.63					2	2	TUBE ASS'Y	6061-T6 0.375 OD x 0.035 W	VWV-T-700/6
D2003-009	T2003-009	12.38	12.44					2	2	TUBE ASS'Y	6061-T6 0.375 OD x 0.035 W	VWV-T-700/6
D2003-011	T2003-011	33.31	32.38					2	2	TUBE ASS'Y	6061-T6 0.375 OD x 0.035 W	VWV-T-700/6
D2003-013	T2003-013	12.7	13.54					2	2	TUBE ASS'Y	6061-T6 0.375 OD x 0.035 W	VWV-T-700/6
D2003-015	T2003-015	17.2	18.00					2	2	TUBE ASS'Y	6061-T6 0.375 OD x 0.035 W	VWV-T-700/6
D2003-017	T2003-017	17.0	16.25					2	2	TUBE ASS'Y	6061-T6 0.375 OD x 0.035 W	VWV-T-700/6
D2003-019	T2003-019	9.8	10.62			2	2			TUBE ASS'Y	6061-T6 0.500 OD x 0.035 W	VWV-T-700/6
D2003-021	T2003-021	N/A	2.25			2	2			TUBE ASS'Y	6061-T6 0.500 OD x 0.035 W	VWV-T-700/6
D2003-023	T2003-023	4.5	5.33			2	2			TUBE ASS'Y	6061-T6 0.500 OD x 0.035 W	VWV-T-700/6
D2003-025	T2003-025	9.8	10.60			2	2			TUBE ASS'Y	6061-T6 0.500 OD x 0.035 W	VWV-T-700/6
D2003-027	T2003-027	7.25	7.38			2	2			TUBE ASS'Y	6061-T6 0.500 OD x 0.035 W	VWV-T-700/6
D2003-029	T2003-029	17.2	18.00			2	2			TUBE ASS'Y	6061-T6 0.500 OD x 0.035 W	VWV-T-700/6
D2003-031	T2003-031	14.6	15.38	2	2					TUBE ASS'Y	CRES 0.500 OD x 0.035 W	AISI 304
D2003-033	T2003-033	29.75	29.62	2	2					TUBE ASS'Y	CRES 0.500 OD x 0.035 W	AISI 304
D2003-035	T2003-035	24.7	27.00	2	2					TUBE ASS'Y	CRES 0.500 OD x 0.035 W	AISI 304
D2003-037	T2003-037	24.81	23.38	2	2					TUBE ASS'Y	CRES 0.500 OD x 0.035 W	AISI 304
D2003-039	T2003-039	34.0	34.00	2	2					TUBE ASS'Y	CRES 0.500 OD x 0.035 W	AISI 304
D2003-041	T2003-041	6.0	5.88	2	2					TUBE ASS'Y	CRES 0.500 OD x 0.035 W	AISI 304
D2003-043	T2003-043	11.7	10.75	2	2					TUBE ASS'Y	CRES 0.500 OD x 0.035 W	AISI 304
D2003-045	T2003-045	3.50	2.44	2	2					TUBE ASS'Y	CRES 0.500 OD x 0.035 W	AISI 304
D2003-047	T2003-047	5.56	5.56	2	2					TUBE ASS'Y	CRES 0.500 OD x 0.035 W	AISI 304
D2003-049	T2003-049	33.2	34.00	2	2					TUBE ASS'Y	CRES 0.500 OD x 0.035 W	AISI 304
D2003-077	T2003-077	N/A	6.25					1	1	JET	6061-T6 0.375 OD x 0.035 W	VWV-T-700/6
D2003-101	T2003-101	13.25	13.13					2	2	TUBE ASS'Y	6061-T6 0.375 OD x 0.035 W	VWV-T-600/6
D2003-103	T2003-103	12.38	12.00					2	2	TUBE ASS'Y	6061-T6 0.375 OD x 0.035 W	VWV-T-600/6
D2003-105	T2003-105	10.75	10.60					2	2	TUBE ASS'Y	6061-T6 0.375 OD x 0.035 W	VWV-T-600/6
D2003-107	T2003-107	12.75	12.25					2	2	TUBE ASS'Y	6061-T6 0.375 OD x 0.035 W	VWV-T-600/6
D2003-109	T2003-109	8.25	8.125			2	2			TUBE ASS'Y	6061-T6 0.500 OD x 0.035 W	VWV-T-600/6
D2003-111	T2003-111	4.75	4.625			2	2			TUBE ASS'Y	6061-T6 0.500 OD x 0.035 W	VWV-T-600/6
D2003-116	T2003-116	4.0								HEATSLEEVE	M2650-20 CRINKLE-SOFT	STRATOFLEX
D2003-120	T2003-120	4.0								HEATSLEEVE	M2650-16 CRINKLE-SOFT	STRATOFLEX
D2003-14	T2003-14	4.0								HEATSLEEVE	M2650-14 CRINKLE-SOFT	STRATOFLEX
D2003-16	T2003-16	4.0								HEATSLEEVE	M2650-16 CRINKLE-SOFT	STRATOFLEX
D2003-205	T2003-205	9.75	9.60					2	2	TUBE ASS'Y	6061-T6 0.375 OD x 0.035 W	VWV-T-700/6
D2003-207	T2003-207	3.75	3.75					2	2	TUBE ASS'Y	6061-T6 0.375 OD x 0.035 W	VWV-T-700/6

24.81"
FE

08.04.17

UNCONTROLLED COPY
SUBJECT TO AMENDMENT
WITHOUT NOTICE
WORK ORDER
NO. 38551



DESIGN <i>[Signature]</i>	DRAWN BY <i>[Signature]</i>	DART AEROSPACE LTD HAWKESBURY, ONTARIO, CANADA	
CHECKED <i>[Signature]</i>	APPROVED <i>[Signature]</i>	DRAWING NO. D2003	REV. B SHEET 2 OF 2
DATE 99.06.08		TITLE 206 CABIN HEATER TUBE ASSEMBLIES NTS	

RELEASED
99.06.04 KE

UNDER REVIEW


06.08.21 CB

Some Flat lengths
and wrong

1/08.04.11

Notes:

- (1) USE STRATOFLEX M2650-6 CRINKLE-SOFT HEATSLEEVE.
- (2) TUBING ASSEMBLIES TO BE CUT AND BENT IN ACCORDANCE WITH TEMPLATES.
- (3) TUBES TO BE FLARED 30° TO MATE WITH FITTINGS MADE TO MS33514.
- (4) ENSURE SEAMLESS TUBING IS USED.
- (5) INSTALL HEATSLEEVE OVER ALL TUBES WITH A DESIGNATED LENGTH OF HEATSLEEVE PER THE PARTS LIST.
- (6) 5052 (WW-T-700/4) TUBING MAY BE SUBSTITUTED WHEN 6061 TUBING IS NOT AVAILABLE.
- (7) 0.049 WALL THICKNESS CRES TUBING MAY BE SUBSTITUTED WHEN 0.035 IS NOT AVAILABLE.
- (8) TOLERANCES ARE PER DART QSI 018 UNLESS OTHERWISE NOTED.

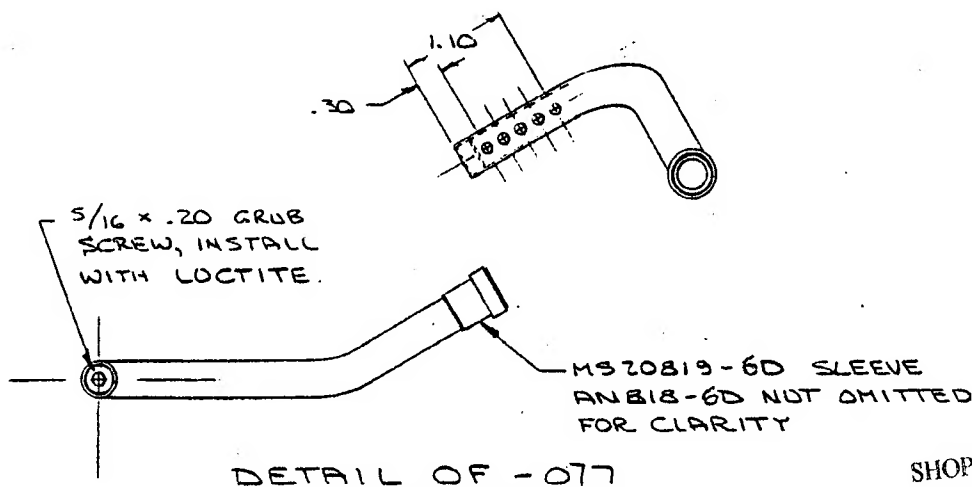

SHOP COPY
RETURN TO
ENGINEERING
UNCONTROLLED COPY
SUBJECT TO AMENDMENT
WITHOUT NOTICE
WORK ORDER
NO. 38557